


BILL OF MATERIAL

ITEM	QTY.	MATERIAL	DESCRIPTION	WEIGHT
------	------	----------	-------------	--------

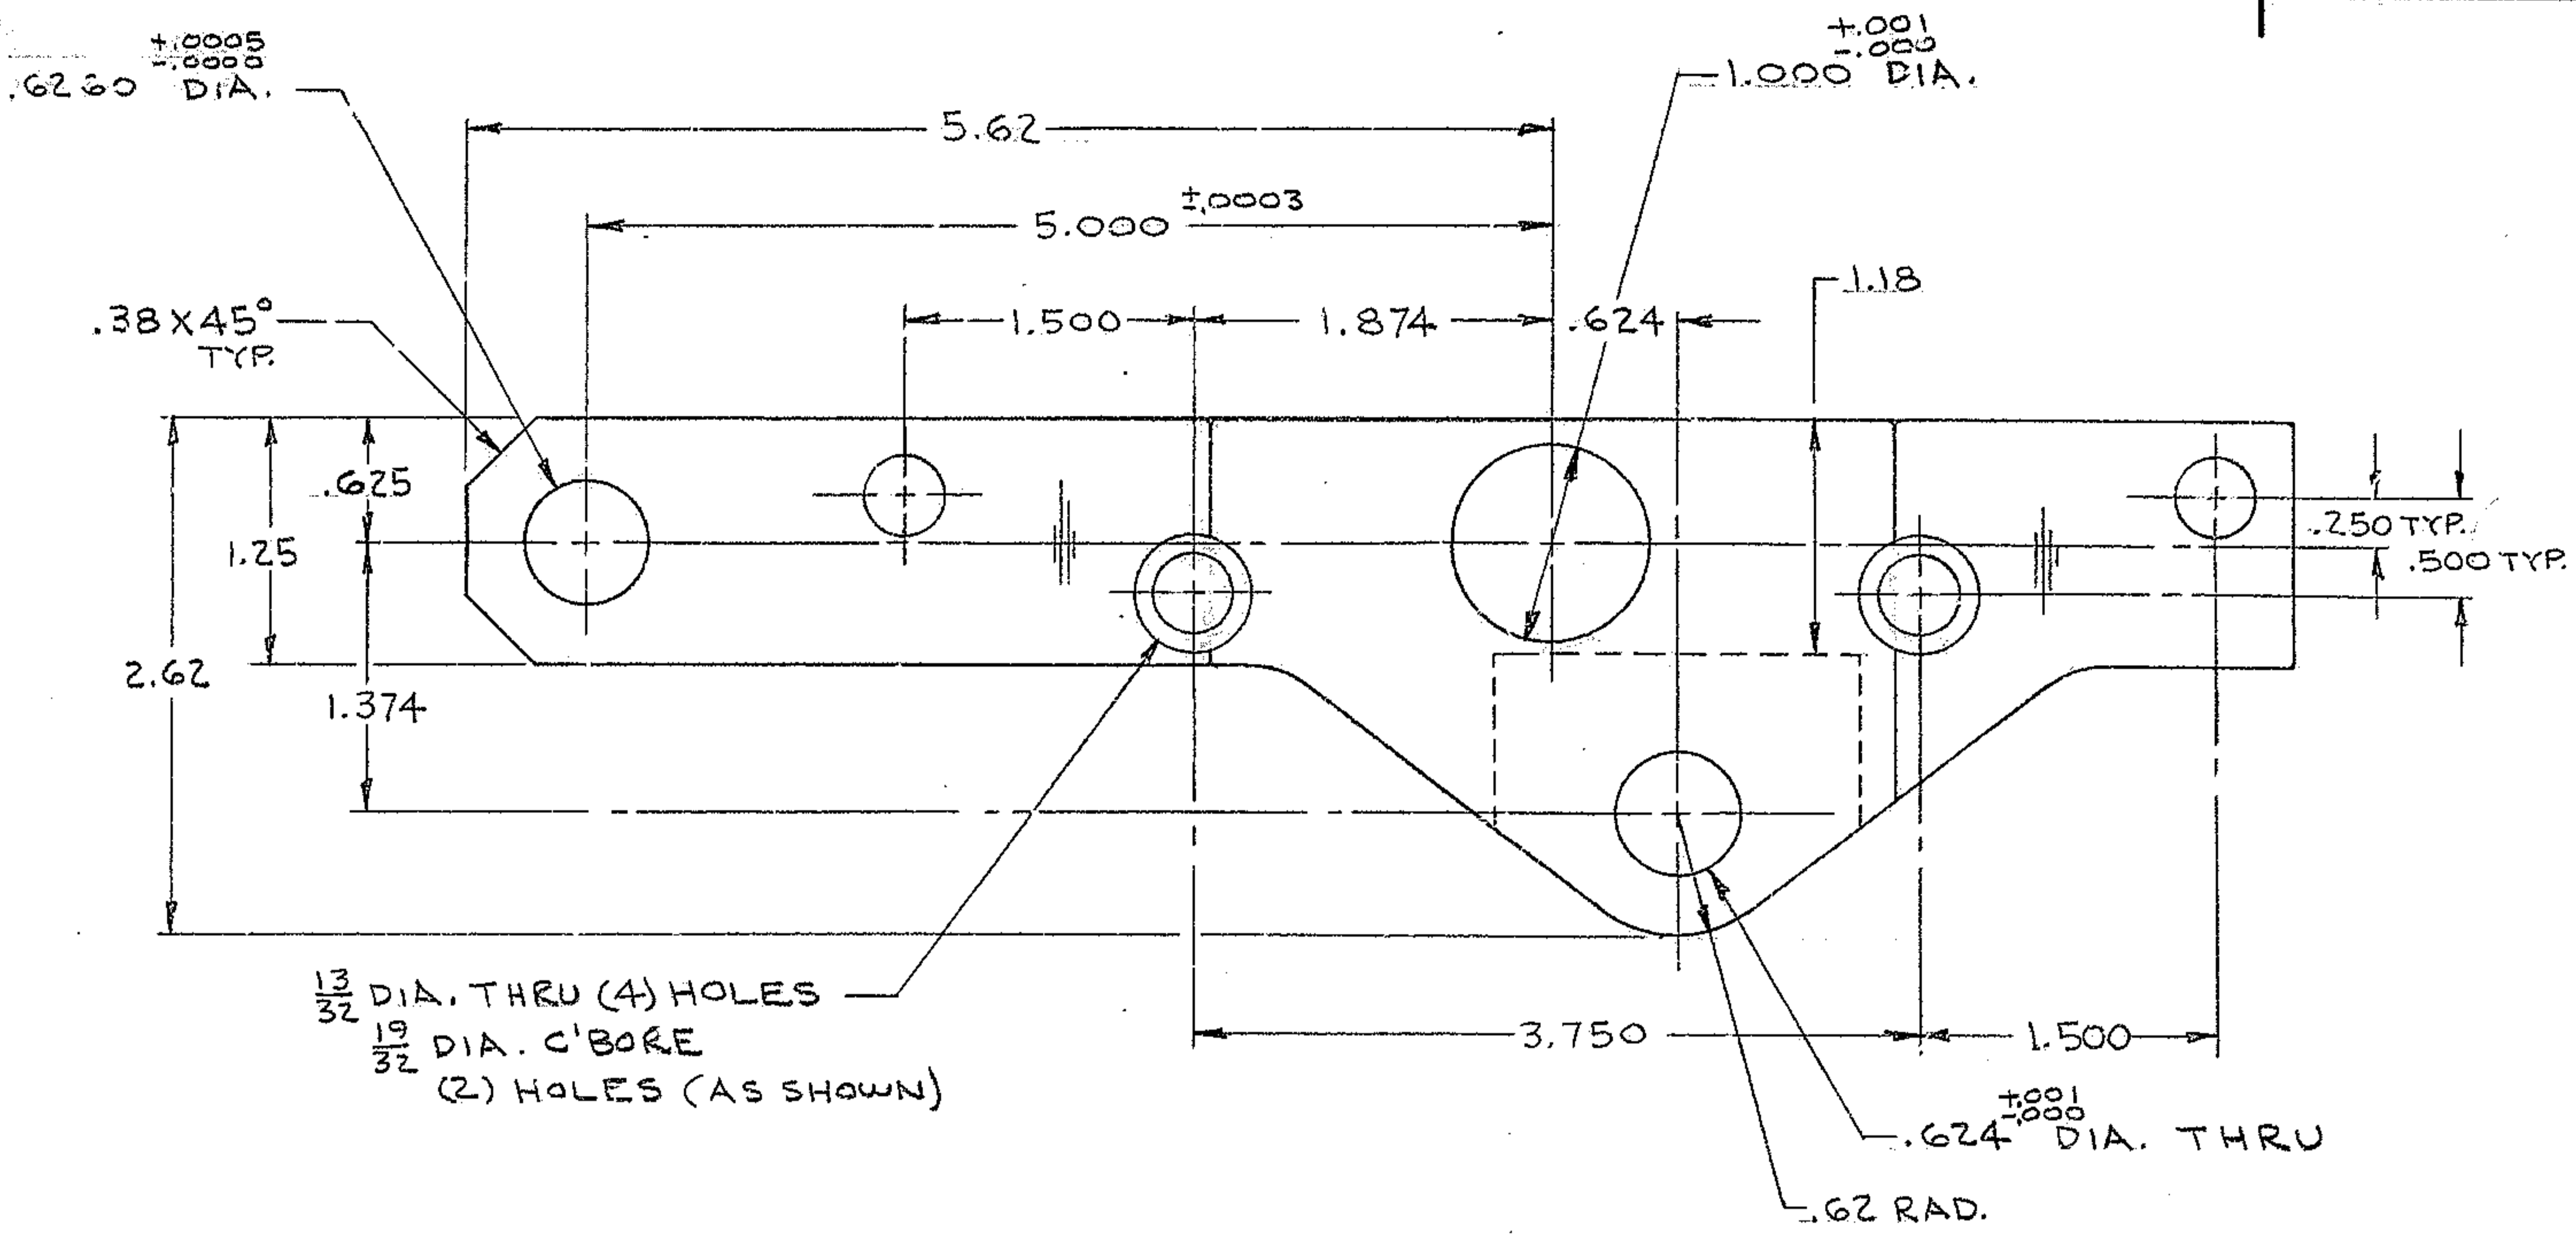

MATERIAL: C 1018 STEEL
 FINISH : CAD PLATE (ALL DIM. TO BE HELD AFTER PLATING)

FOR ASSEMBLY SEE 2150.530E302

<p>TOLERANCES UNLESS OTHERWISE NOTED</p> <p>DECIMAL DIMENSIONS 00.00 ±.010 00.000 ±.003</p> <p>FRACTIONAL DIMENSIONS UP TO 18' ± 1/64 18' TO 50' ± 1/32 50' & OVER ± 1/16</p> <p>BREAK SHARP EDGES 1/32</p> <p>ALL SURFACES TO HAVE 125 ✓ FINISH UNLESS OTHERWISE NOTED.</p>					<p>KITT PEAK NATIONAL OBSERVATORY</p> <p>OPERATED BY THE ASSOCIATION OF UNIVERSITIES FOR RESEARCH IN ASTRONOMY, INC. UNDER CONTRACT WITH NATIONAL SCIENCE FOUNDATION</p>		
					150 INCH STELLAR TELESCOPE		REF. FILE 1193
					NAME ARM, L.H. ROCKER-SECONDARY FLIP LOCK ASSY.		SCALE FULL
							PRINT ISSUED
DESIGNED BY	DATE	APPROVED BY	DATE	DRAWING NUMBER 2150.530C317	REV. A		
DRAWN BY	DATE	APPROVED BY	DATE				
CHECKED BY	DATE	APPROVED BY	DATE				
LET.	REVISION	ECR	DATE			BY	
A	AS BUILT CHANGE	0670	5/13/70				