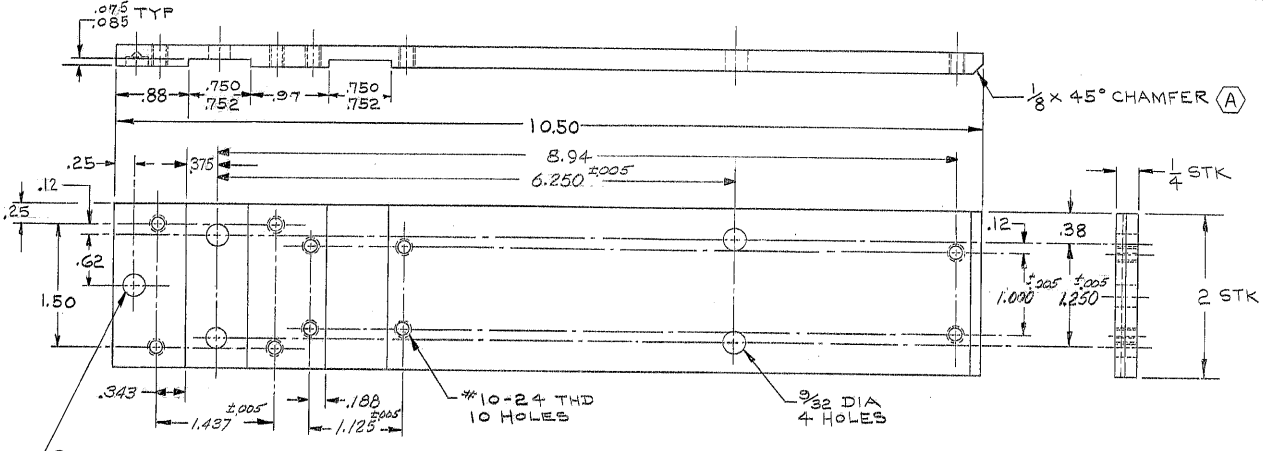

MATL: H.R. STL 1/4 x 2 BAR STK

5-FINISH: CADMIUM PLATE
4-BREAK SHARP EDGES .02
3-IDENTIFY BY ~~[illegible]~~ AT LOCATION -3- "AURA INC. MADE IN U.S.A."
~~2-STAMP MATCH MARKS ON ALL MATING PARTS WHERE NECESSARY.~~
1-FOR NEXT ASSY. SEE 2150.130-D302 & -D402
NOTES-

LET.	REVISION ON	ECR	DATE	BY
A	ADDED 1/8 x 45° CHAMFER	0242	1-4-73	F.L.B.

TOLERANCES UNLESS OTHERWISE NOTED
DECIMAL DIMENSIONS 00.00 ±.010 00.000 ±.003
FRACTIONAL DIMENSIONS UP TO 18" ± 1/64 18" TO 50" ± 1/32 50" & OVER ± 1/16
ANGLES ± 0° -30'
ALL SURFACES TO HAVE 125 FINISH UNLESS OTHERWISE NOTED.

		DATE	APP'D BY	DATE
DEs'D BY	F. HENDY	6-16-72	F. HENDY	7-24-72
DRN BY	D.L.B.	7-20-72	[illegible]	7-24-72
CH'KD BY	J. SHIVELY	8-7-72		
APP'D BY		DATE		

KITT PEAK NATIONAL OBSERVATORY
OPERATED BY THE ASSOCIATION OF UNIVERSITIES FOR RESEARCH IN ASTRONOMY, INC. UNDER CONTRACT WITH NATIONAL SCIENCE FOUNDATION

150 INCH STELLAR TELESCOPE — REF. FILE 11.56

NAME: MOUNTING PLATE THRUST BRG. INNER L.S. ASSY

SCALE: FULL — PRINT ISSUED

DRAWING NUMBER: 2150.130-B020 — REV. A

5/71 DIETERICH-POST CLEARPRINT 1020