BILL OF MATERIAL

ITEM	QTY.	MATERIAL	DESCRIPTION	WEIGHT

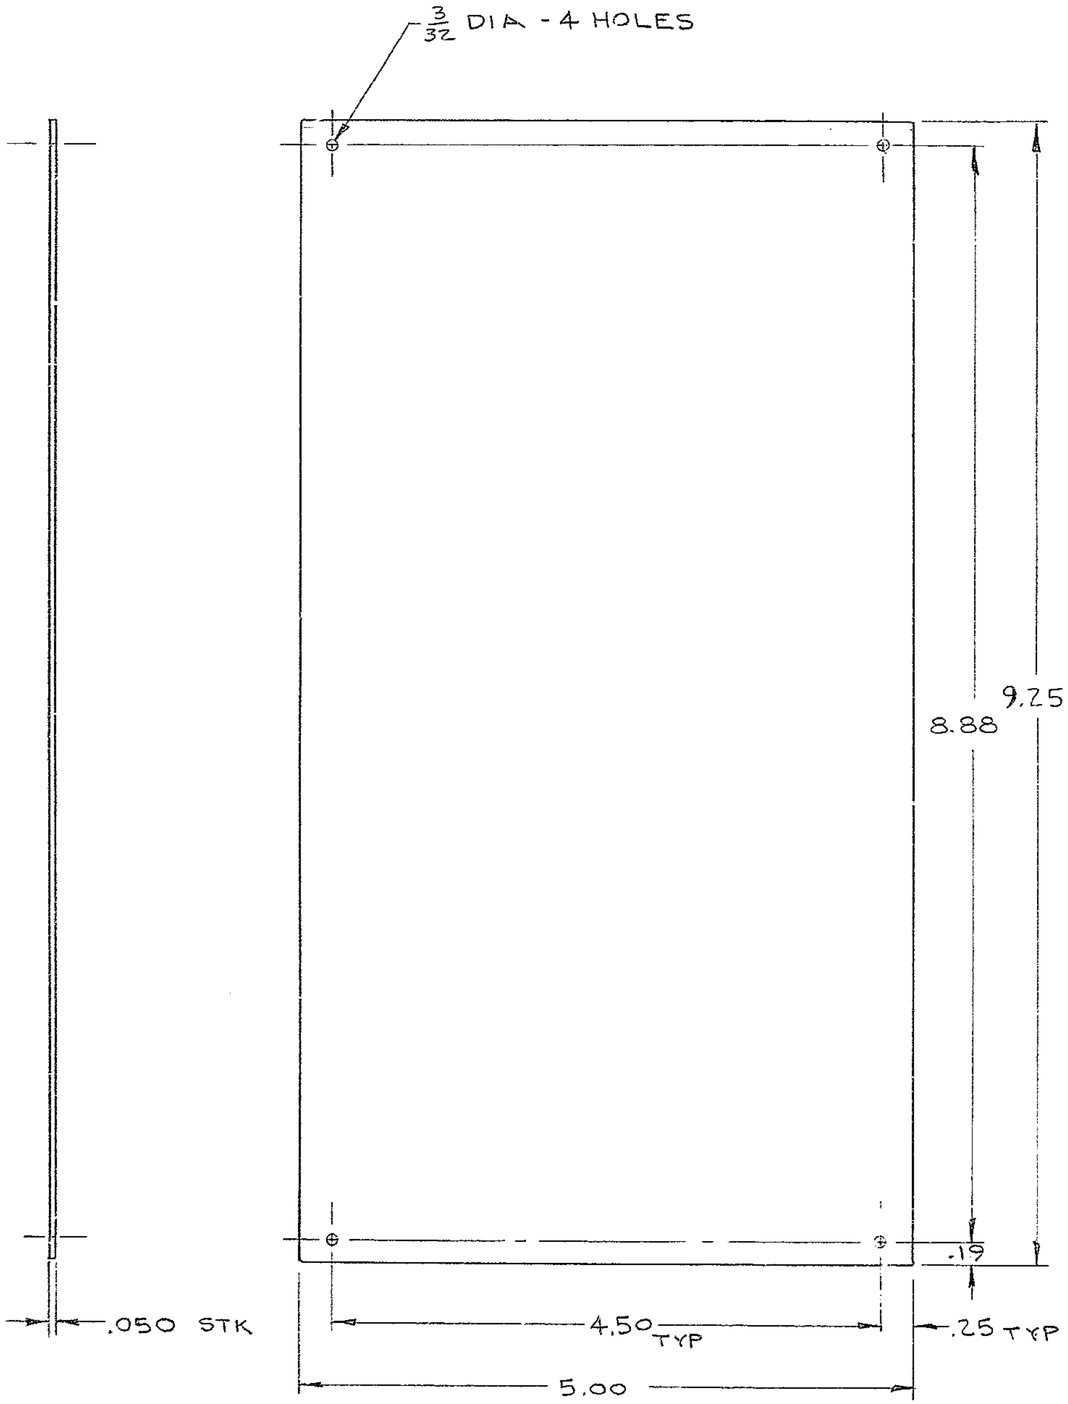

MAT'L: 6061-T6 AL ALLOY
19 REQ'D, HARD ANODIZE

5-BREAK SHARP EDGES .01

~~4-IDENTIFY BY AT LOCATION 4 , "AURA INC. MADE IN U.S.A."~~

~~3-STAMP MATCH MARKS ON ALL MATING PARTS WHERE NECESSARY.~~

2-PROJECT DRAWINGS

1-FOR NEXT ASSY. SEE 2150.284-E202

NOTES-

LET.	REVISION	ECR	DATE	BY
A	MATERIAL WAS 2024-T3	0786	2-18-72	JBZ. RAC

TOLERANCES UNLESS OTHERWISE NOTED

DECIMAL DIMENSIONS
00.00 ±.010
00.000 ±.003

FRACTIONAL DIMENSIONS
UP TO 18" ± 1/64
18" TO 50" ± 1/32
50" & OVER ± 1/16

ANGLES ± 0° −30'

ALL SURFACES TO HAVE 125 √ FINISH UNLESS OTHERWISE NOTED.

KITT PEAK NATIONAL OBSERVATORY

OPERATED BY THE
ASSOCIATION OF UNIVERSITIES FOR RESEARCH IN ASTRONOMY, INC.
UNDER CONTRACT WITH
NATIONAL SCIENCE FOUNDATION

150" TELESCOPE

REF. FILE 1177

NAME PLATE, BOTTOM-
E. DEC. CABLE WRAP-UP ASSY

SCALE FULL

PRINT ISSUED

DESIGNED BY	DATE	APPROVED BY	DATE
JBZ	1-20-72		
DRAWN BY JBZ	DATE 1-20-72	APPROVED BY ZKR	DATE 2-3-72
CHECKED BY R. CHADD	DATE 2-3-72	APPROVED BY EG.	DATE 1-21-72

DRAWING NUMBER 2150.284-C208

REV. A

5/71 DIETERICH-POST CLEARPRINT 1020-10