


BILL OF MATERIAL

ITEM	QTY.	MATERIAL	DESCRIPTION	WEIGHT
------	------	----------	-------------	--------

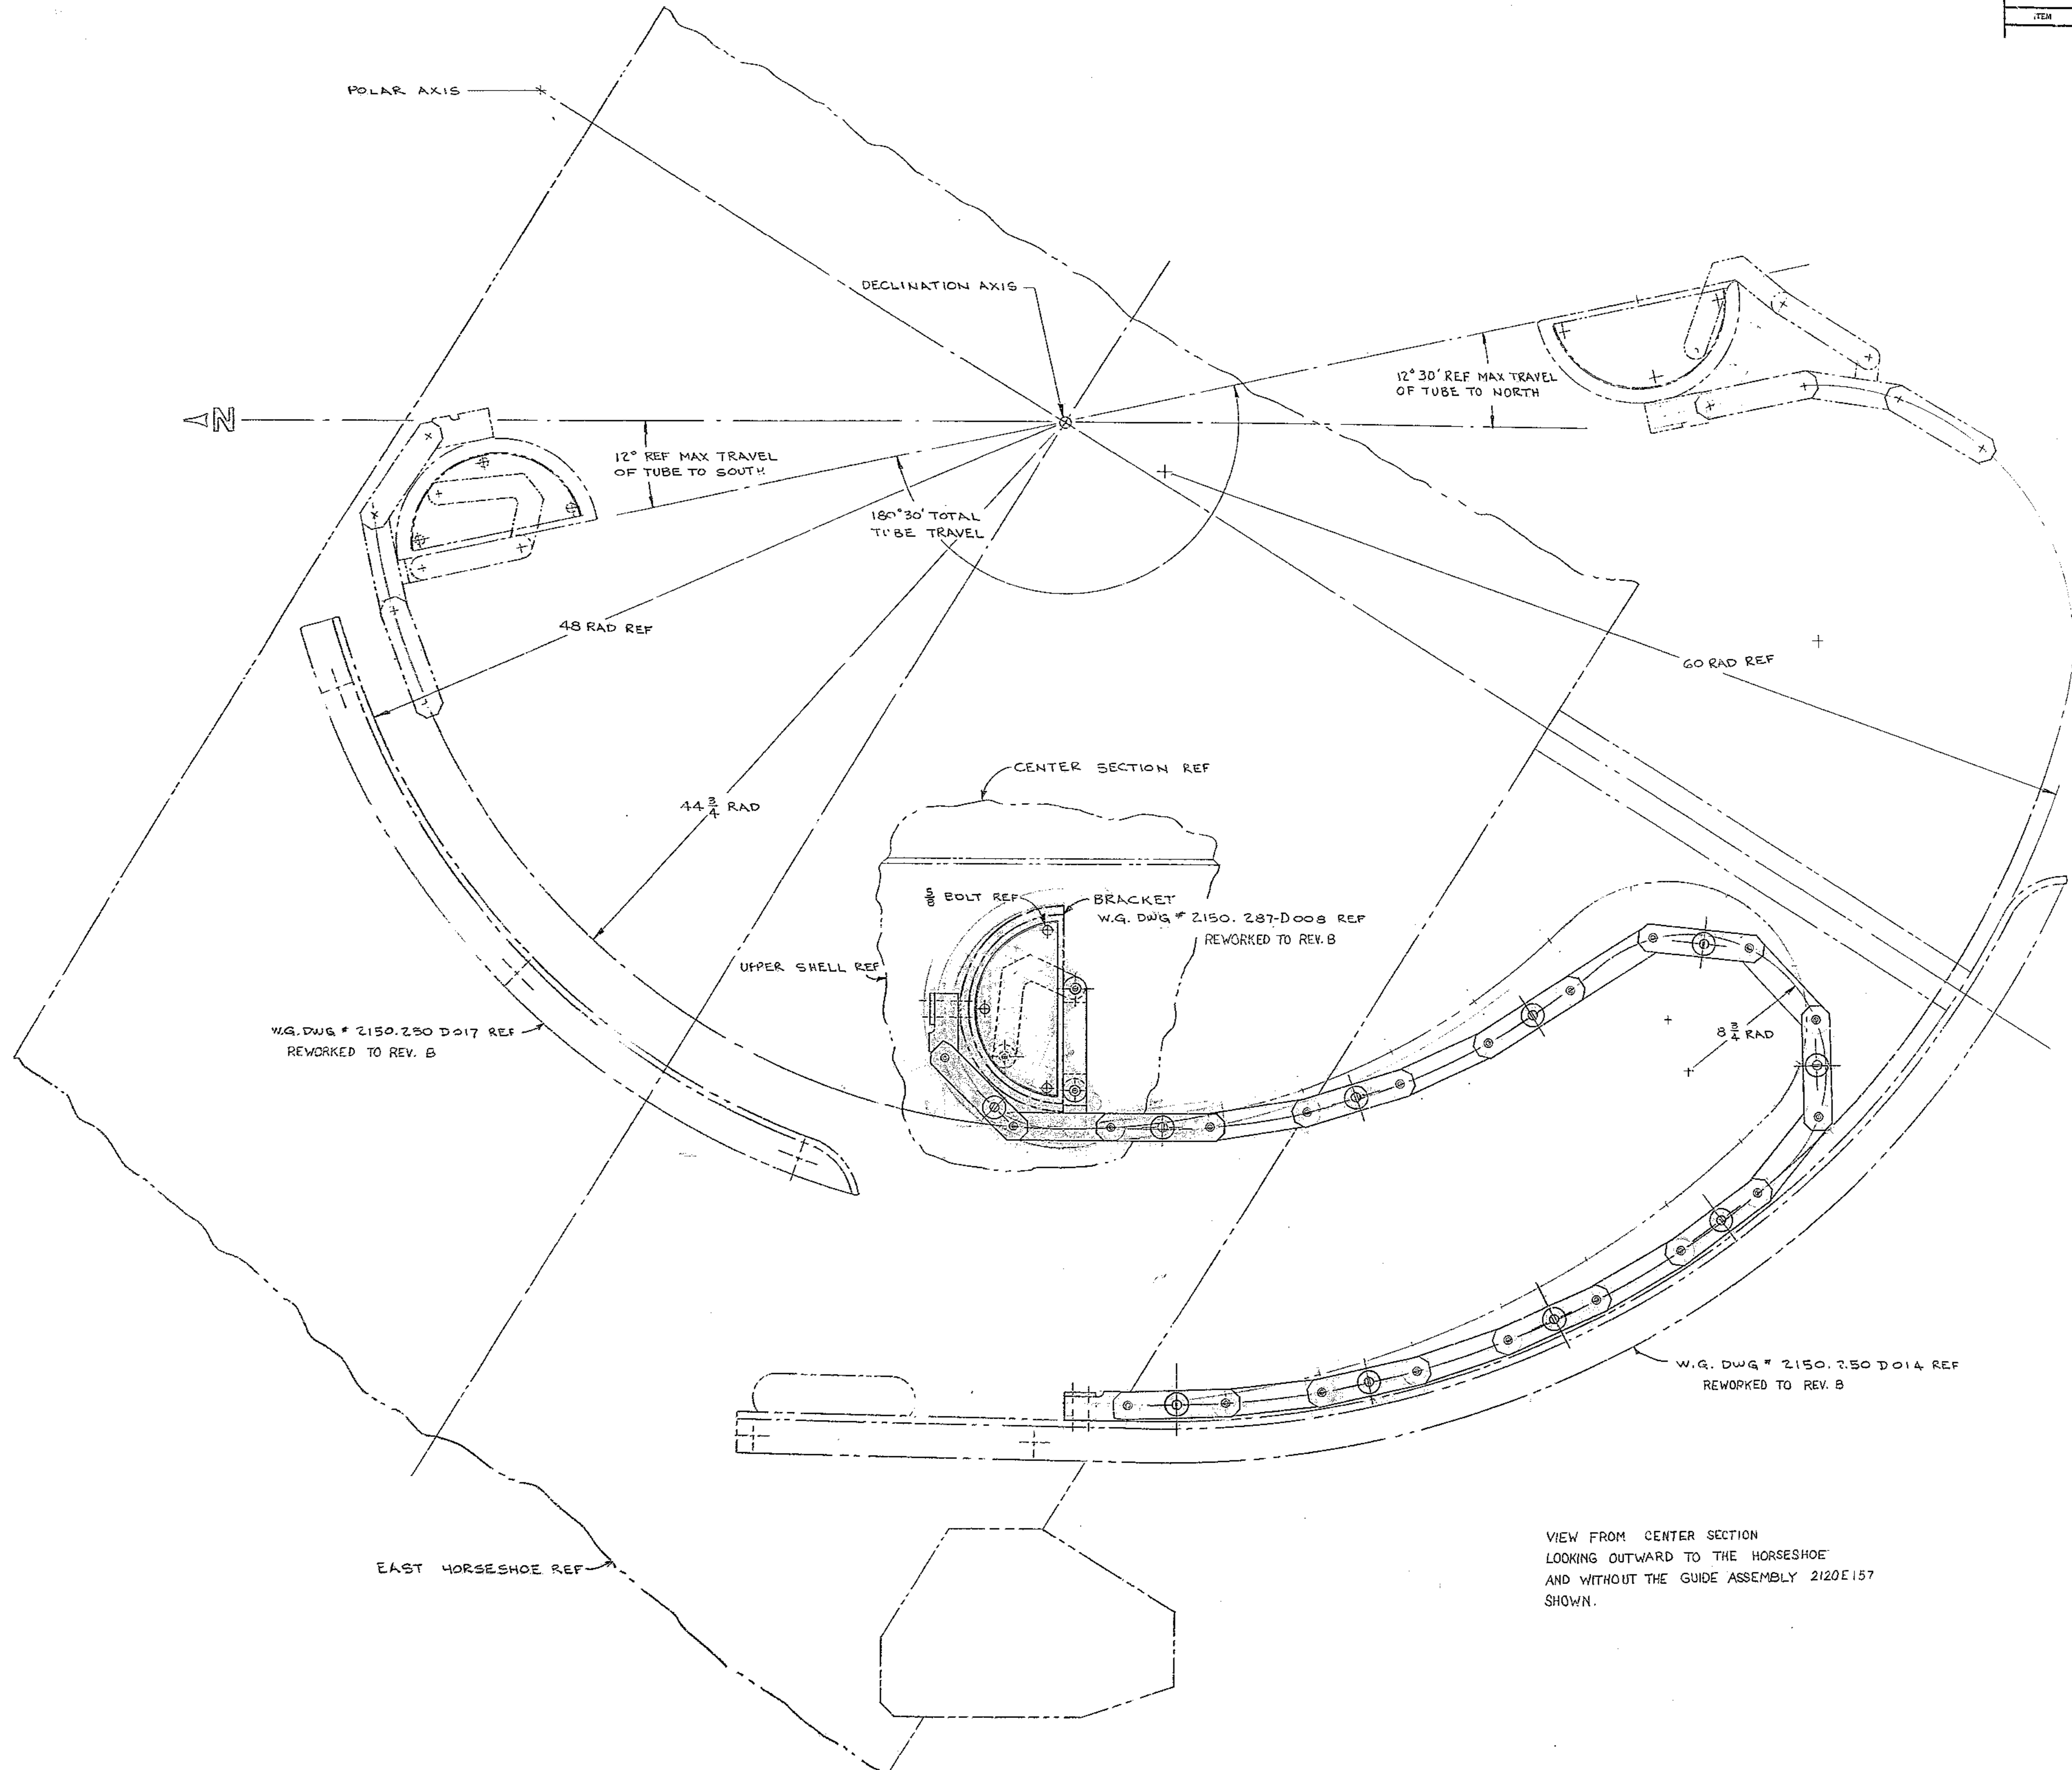

VIEW FROM CENTER SECTION
LOOKING OUTWARD TO THE HORSESHOE
AND WITHOUT THE GUIDE ASSEMBLY 2120E157
SHOWN.

- 5-BREAK-SHARP EDGES
- 4-IDENTIFY BY _____ AT LOCATION _____ "AURA INC. MADE IN U.S.A."
- 3-STAMP-MATCH-MARKS-ON-ALL-MATING-PARTS-WHERE-NECESSARY
- 2-PROJECT DRAWINGS
- 1-FOR NEXT ASSY. SEE 2150.250-E 003 (5 of 5)

NOTES:

TOLERANCES UNLESS OTHERWISE NOTED			
DECIMAL DIMENSIONS	0.005 ± 0.010	0.000 ± 0.003	
FRACTIONAL DIMENSIONS	UP TO 18" ± 1/64	18" TO 60" ± 1/32	60" & OVER ± 1/16
ANGLES	± 30'		
ALL SURFACES	TO HAVE V FINISH		
	UNLESS OTHERWISE NOTED.		

KITT PEAK NATIONAL OBSERVATORY
OPERATED BY THE ASSOCIATION OF UNIVERSITIES FOR RESEARCH IN ASTRONOMY, INC.
UNDER CONTRACT WITH NATIONAL SCIENCE FOUNDATION

150" TELESCOPE REF. FILE 1177
SCALE 1/4"
NAME OUTLINE - EAST DECLINATION CABLE WRAP-UP ASSY. PRINT ISSUE

DESIGNED BY	DATE	APPROVED BY	DATE	DRAWING NUMBER	REV.
W.G. # 2150	11-15-71	W.G. # 2150	11-15-71	2150.284-E 201	A
CHECKED BY	DATE	APPROVED BY	DATE		
W.G. # 2150	11-15-71	W.G. # 2150	11-15-71		
LET.	REVISION	ECR	DATE	BY	
A	AS BUILT		2288	7/7/73	CS